

CITY OF BALTIMORE  
DEPARTMENT OF PUBLIC WORKS  
OFFICE OF ENGINEERING AND CONSTRUCTION

**ADDENDUM NO. 2**

September 18, 2024

**FOR DRAWINGS, SPECIFICATIONS, PROPOSAL, CONTRACT, AND BOND**

**FOR  
SANITARY CONTRACT NO. 982R – EASTERN AVENUE PUMPING STATION  
REHABILITATION**

FOR THE MAYOR AND CITY COUNCIL OF BALTIMORE

---

TO BIDDERS: PLEASE ATTACH TO YOUR CONTRACT DOCUMENTS. THIS ADDENDUM IS HEREBY MADE A PART OF THE CONTRACT DOCUMENTS ON WHICH THE CONTRACT WILL BE BASED, AND IS ISSUED TO MODIFY, EXPLAIN AND/OR CORRECT THE ORIGINAL DRAWINGS AND SPECIFICATIONS. PLEASE ACKNOWLEDGE THIS ADDENDUM ON THE BID PROPOSAL PAGE WHERE INDICATED. IF THIS DOCUMENT HAS BEEN RECEIVED VIA EMAIL, A CONFIRMATION EMAIL REPLY MUST BE SENT BY BIDDER WITHIN 24 HOURS CONFIRMING RECEIPT OF THE ADDENDUM TO [DPWCONTRACTADMIN@BALTIMORECITY.GOV](mailto:DPWCONTRACTADMIN@BALTIMORECITY.GOV) . IF EMAIL ACKNOWLEDGMENT IS NOT RECEIVED BY DPW, YOUR BID MAY BE REJECTED.

---

APPROVED:

*Timothy Wolfe*

---

TIMOTHY W. WOLFE, P.E., BCEE  
CHIEF  
OFFICE OF ENGINEERING AND CONSTRUCTION

*Khalil Zaid*

---

KHALIL ZAIED  
ACTING DIRECTOR  
DEPARTMENT OF PUBLIC WORKS

## **I – REVISIONS TO THE CONTRACT BOOK**

No Contract Book revisions included in Addendum No. 2.

## **II – REVISIONS TO THE CONTRACT DRAWINGS**

### **DRAWING H02-701 (SHEET 86 OF 148)**

**Replace** the drawing with the revised Drawing H02-701 in Attachment 1 of this Addendum.

## **III – QUESTIONS FROM BIDDERS – RESPONSE IN BOLD**

1. Bid Item 101 Mobilization states “Not to Exceed 5%”. The activities listed under section 01 29 00 1.04.A cannot be covered under the “Not to Exceed 5%”. This cap requires the contractor to finance the project and therefore increases the overall cost of the project to the City. The contractor requests that the City increase this to a minimum of 10% cap.

**Response: Bid as specified.**

2. On the MBE/WBE form Part B, the language has been changed since the original bid. Underneath “Percentage of work to be performed by MBE or WBE:” it states “MUST BE A WHOLE NUMBER, NO DECIMAL PLACES”. In order to achieve the high goal set by the City, several MBE’s and WBE’s will need to be utilized, which almost always results in fractions of percentages being shown on this form. Please clarify the intent of this statement. Is it acceptable for an individual MBE or WBE to perform a fractional percentage of the work (i.e. 3.92%), but the number shown here is simply shown as rounded to the nearest whole number (4%) without changing the dollar value of work performed?

**Response: This is the updated City MBE/WBE form. Yes, Contractors may round to the nearest whole number to not use fractions on this form.**

3. Drawing I02-602 shows a 3-Hole local control station for the screen (HOA, FOR, E-Stop). Specification 46 21 16, page 14 appears to indicate a 7-Hole LCS for each screen, including HOA, FOR, E-Stop, Power LT, Run LT, Fail LT, Reset. Please advise if 3-Hole local control stations can be provided as this would be typical.

**Response: The referenced apparent discrepancy could not be located. Drawing I02-602 shows a total of seven (7) devices per each multi-rake bar screen local control station. Please bid as specified.**

4. Section 40 90 00, page 13 requires a NEMA 4X and Class 1, Div. 2 rated HydroRanger controller. Please confirm that the HydroRanger controllers will be in a Class 1, Division 2 environment such that a NEMA 4X fiberglass enclosure is acceptable. If in Class 1,

Div 1 then a NEMA 7 cast aluminum enclosure would be needed.

**Response: Please refer to Drawing I02-602, which specifies that the multi-rake bar screen level instrument controllers be factory-mounted within the multi-rake bar screen control panels. Please bid as specified.**

5. Section 46 21 16-2.03.N.5.c requires a PLC to be provided as outlined in Div. 40. Section 40 94 43 defines the PLC for the pump station control panel, which is using a Modicon M580, BMEH582040 CPU. We would use a Modicon M340 PLC for the screen control panels, please confirm that Modicon M340 PLC platform will be acceptable for the screen control panels, one PLC per panel.

**Response: Please refer to Specification 40 94 43, Paragraph 2.06, which defines requirements for PLCs in packaged control panels from equipment manufacturers. Please bid as specified.**

REVISIONS			
NO.	DESCRIPTION	DATE	BY
1	ADDENDUM No. 2	09/13/2024	

**GENERAL CONTROL NOTES AND REQUIREMENTS:**


- THESE CONTROL DRAWINGS INDICATE SYSTEMS TO BE CONTROLLED BY STANDALONE MEANS AS WELL AS INTENDED SEQUENCES OF OPERATION.
- THE CONTROL SYSTEM SHALL BE FULLY INSTALLED, CALIBRATED AND ADJUSTED TO PROVIDE ACCURATE AND STABLE SYSTEM OPERATION. CONTROLLED PARAMETERS SHALL BE MAINTAINED WITHIN ACCEPTABLE RANGES AND PID TUNING SHALL BE PERFORMED TO PROVIDE STABLE OPERATION WITHIN 5 MINUTES OF A PARAMETER CHANGE. THE ENGINEER AND COMMISSIONING AUTHORITY WILL EVALUATE THE SYSTEM TO VERIFY THAT PROPER INSTALLATION AND SYSTEM SETUP/TUNING HAS BEEN PERFORMED ONLY AFTER WRITTEN DOCUMENTATION FROM THE CONTROLS CONTRACTOR, INCLUDING GRAPHICAL TRENDING DATA, HAS BEEN SUBMITTED INDICATING THAT THE CONTROL INSTALLATION AND SETUP IS COMPLETE.
- CONTROL SUBMITTALS SHALL INCLUDE SYSTEM SCHEMATICS, WIRING DIAGRAMS AND CONTROL LOGIC TO BE USED TO ACHIEVE INTENDED SEQUENCES OF OPERATION - SIMPLY REPRODUCING SEQUENCES AS PROVIDED IN THESE DRAWINGS OR SUBMITTING CONTROL SEQUENCES DIRECTLY FROM EQUIPMENT SUBMITTALS WILL NOT BE ACCEPTABLE.
- POINTS LISTS SHALL BE DEVELOPED BY THE BAS SUPPLIER, BASED ON THE SCHEMATICS AND SEQUENCES PROVIDED HERE, AND SUBMITTED TO THE ENGINEER FOR REVIEW.
- POWER FOR CONTROL SYSTEMS AND EQUIPMENT SHALL BE PROVIDED BY THE CONTRACTOR IN ACCORDANCE WITH DIVISION 26 REQUIREMENTS. ALL POWER FOR CONTROL SYSTEMS SHALL BE INDEPENDENT OF EQUIPMENT LOW VOLTAGE DC SERVICE.
- VALVE AND DAMPER ACTUATORS ARE NOTED WITH "NO" AND "NC" FOR NORMALLY OPEN AND NORMALLY CLOSED, INDICATING SPRING RETURN ORIENTATION.
- WHERE ADJUSTABLE TEMPERATURE SETPOINTS ARE NOT IDENTIFIED, A +/- 2°F DEADBAND (ADJ.) SHALL BE PROVIDED.
- ALL SETPOINTS, RESET SCHEDULES AND DEADBANDS IDENTIFIED HEREIN SHALL BE ADJUSTABLE BY THE BUILDING OPERATOR.

**CONTROLS ABBREVIATIONS**

<b>"X"</b>	<b>"X-Y"</b>	<b>"Y"</b>
C COMPRESSOR	A AMPERAGE	E ENTHALPY
E ENTHALPY	DPR DAMPER	DPS DIFFERENTIAL PRESSURE SENSOR
EA EXHAUST AIR	E ENTHALPY	E ENTHALPY
EF EXHAUST FAN	KW KILOWATT	KWH KILOWATT-HOUR
ERV ENERGY RECOVERY VENTILATOR	MOD MODULATION (%)	RH RELATIVE HUMIDITY (%)
F FILTER	SP STATIC PRESSURE	SS START/STOP
FRZ FREEZE STAT	SW SWITCH ON/OFF	T TEMPERATURE
LA LEAVING AIR	TS TEMPERATURE SENSOR	V VOLTAGE
MA MIXED AIR		
OA OUTDOOR AIR		
RA RETURN AIR		
SA SUPPLY AIR		
SF SUPPLY FAN		
TA TEMPERED AIR		
VRF VARIABLE REFRIGERANT FLOW INDOOR UNIT		
VRF-HR VARIABLE REFRIGERANT FLOW ENERGY RECOVERY MODULE		
VRF-O VARIABLE REFRIGERANT FLOW OUTDOOR UNIT		
ZN ZONE		

**CONTROLS DESIGNATIONS**


- "Y"** VISUAL DISPLAY DEVICE MOUNTED ON SIDE OF DUCT OR UNIT
- "X-Y"** POINT(S) INTEGRATED OR HARD WIRED TO BAS
- "X" R** INDICATED GRAPHICAL DISPLAY POINT (MUST APPEAR ON SYSTEM GRAPHIC)
  - R (REQUESTED) = SETPOINT FOR A THERMOSTAT, DAMPER, VALVE, ETC.
  - A (ACTUAL) = POSITIVE POSITION FEEDBACK, TEMPERATURE SENSOR INPUT, ETC.
  - O (ORIGINAL) = VALUE ESTABLISHED DURING INITIAL SYSTEM COMMISSIONING.

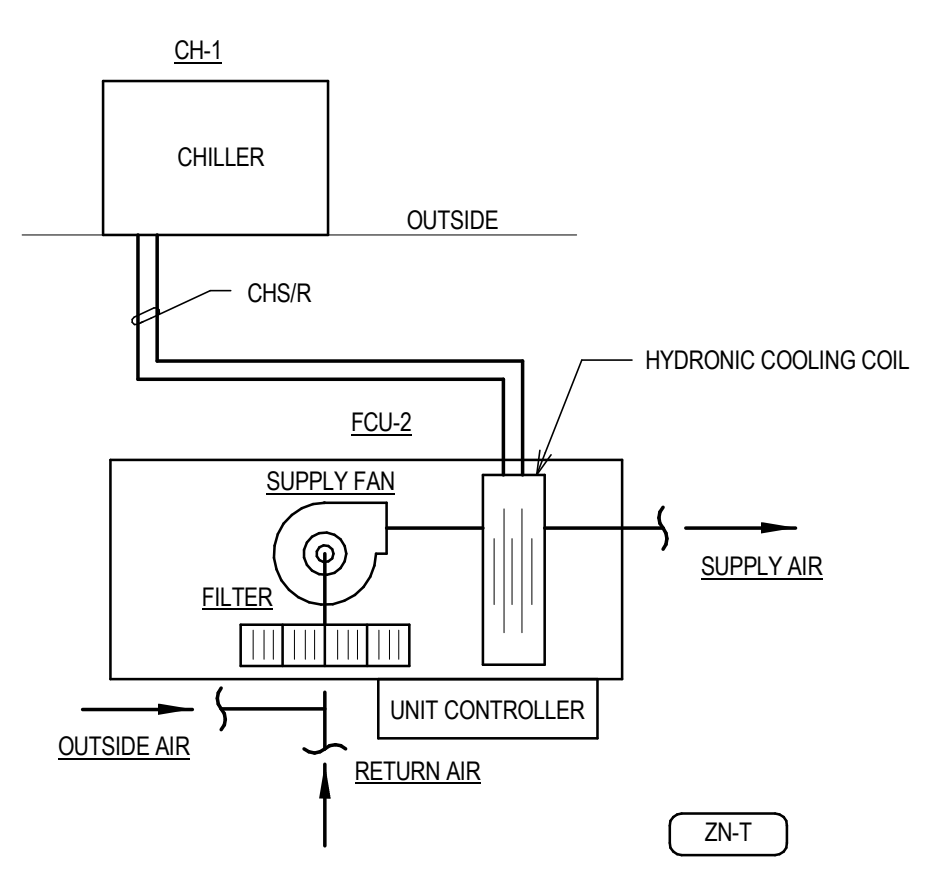

**1 FAN COIL UNIT**  
SCALE: NTS

**A. GENERAL:**  
THE HYDRONIC FAN COIL UNIT PROVIDES COOLING TO THE LOCKER ROOMS. THE UNIT IS CONTROLLED VIA A LOCAL CONTROLLER AND A WALL MOUNTED THERMOSTAT.


**B. SPLIT SYSTEM FAN COIL UNIT OPERATION:**  
THE FAN COIL UNIT (FCU-1) INTERNAL CONTROLS SHALL RUN THE SUPPLY FAN CONTINUOUSLY AS NEEDED TO MEET THE ZONE TEMPERATURE SETPOINT AS SELECTED ON THE ZONE THERMOSTAT.

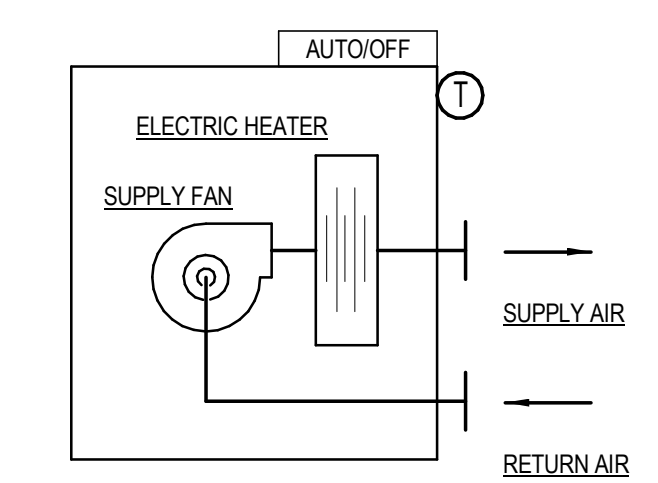

**2 ELECTRIC UNIT HEATER**  
SCALE: NTS


**A. GENERAL:**  
THE ELECTRIC UNIT HEATER (EUH) SHALL BE PROVIDED WITH A CONSTANT VOLUME FAN, ELECTRIC HEATER, AUTO-OFF SELECTOR SWITCH, AND THERMOSTAT.

**B. UNIT HEATER OPERATION:**  
THE EUH SHALL BE ENABLED THROUGH THE AUTO/OFF SWITCH. WHEN THE SWITCH IS SET TO AUTO, THE EUH SHALL CYCLE THROUGH INTERNAL CONTROLS TO MAINTAIN TEMPERATURE SETPOINT OF 65°F (ADJ. +/- 2°F DEADBAND) AT THE THERMOSTAT. WHEN THE SWITCH IS SET TO OFF, THE EUH SHALL BE DE-ENERGIZED. THE STANDALONE ELECTRIC UNIT HEATER SHALL NOT BE MONITORED.

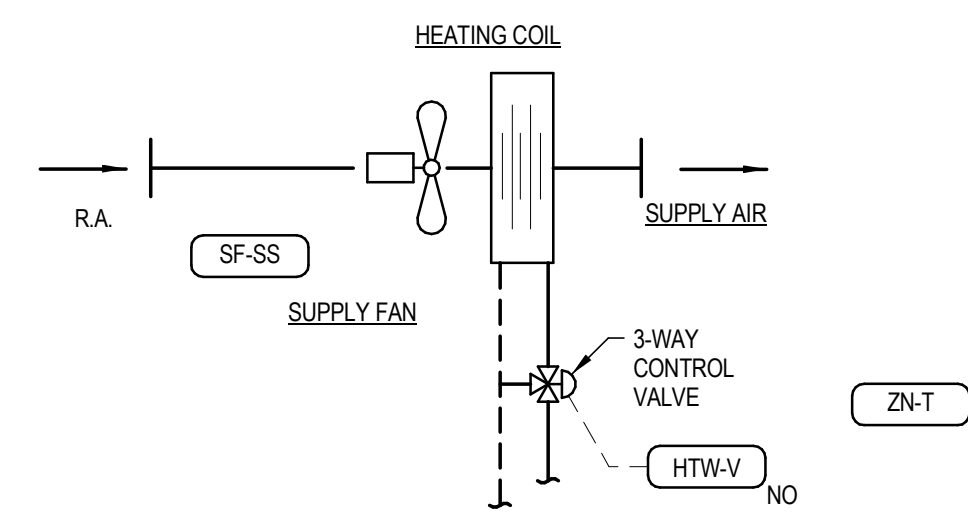


**3 HYDRONIC UNIT HEATER**  
SCALE: NTS

**A. GENERAL:**  
THE UH SHALL BE ENABLED THROUGH THE AUTO/OFF SWITCH. WHEN THE SWITCH IS SET TO AUTO, THE UH SHALL CYCLE THROUGH THERMOSTATIC CONTROLS TO MAINTAIN TEMPERATURE SETPOINT OF 65°F (ADJ. +/- 2°F DEADBAND) AT THE THERMOSTAT. WHEN THE SWITCH IS SET TO OFF, THE UH SHALL BE DE-ENERGIZED.

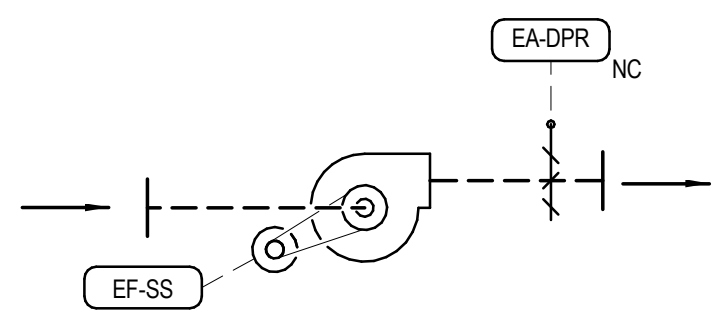


**4 EXHAUST FAN (EF-1, 2, 3, 4, 5, 6)**  
SCALE: NTS

**A. GENERAL:**  
THE CONSTANT VOLUME EXHAUST FAN SHALL BE ENERGIZED AT THE EQUIPMENT DISCONNECT TO OPERATE 24-HOURS PER DAY.

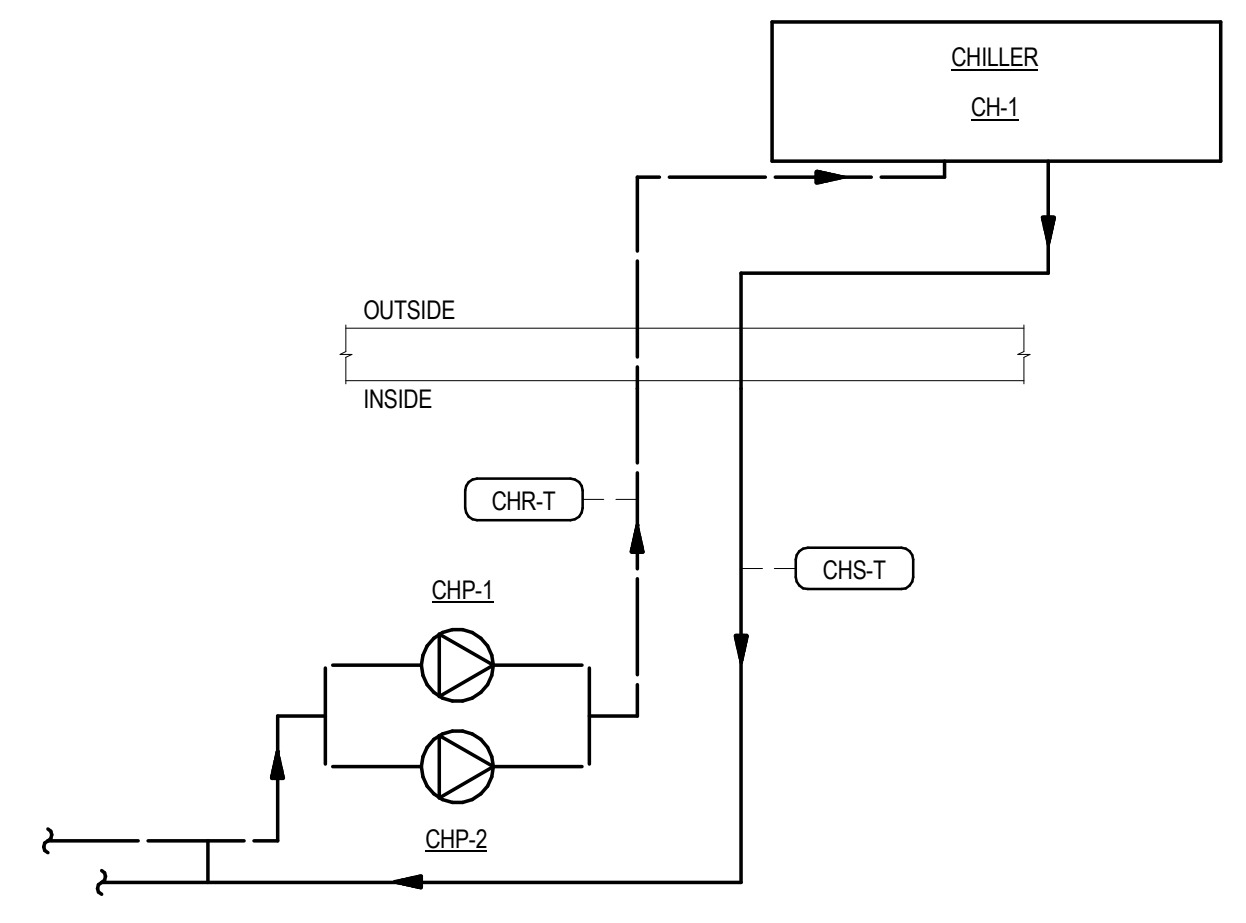


**5 CHILLER AND CHILLED WATER PUMPS**  
SCALE: NTS

**A. GENERAL:**  
UPON PROOF OF FLOW AT THE FACTORY PROVIDED FLOW SWITCH, THE AIR-COOLED CHILLER SHALL OPERATE ON INTERNAL CONTROLS TO SUPPLY CHILLED WATER AT TEMPERATURE OF 42 DEG F (ADJ.). THE CHILLED WATER PUMPS SHALL OPERATE IN A LEAD-STANDBY CONFIGURATION UPON A FAILURE OF THE LEAD PUMP THE STANDBY PUMP SHALL BE ENABLED. PUMP ENABLE SIGNAL SHALL BE PROVIDED BY THE CHILLER.

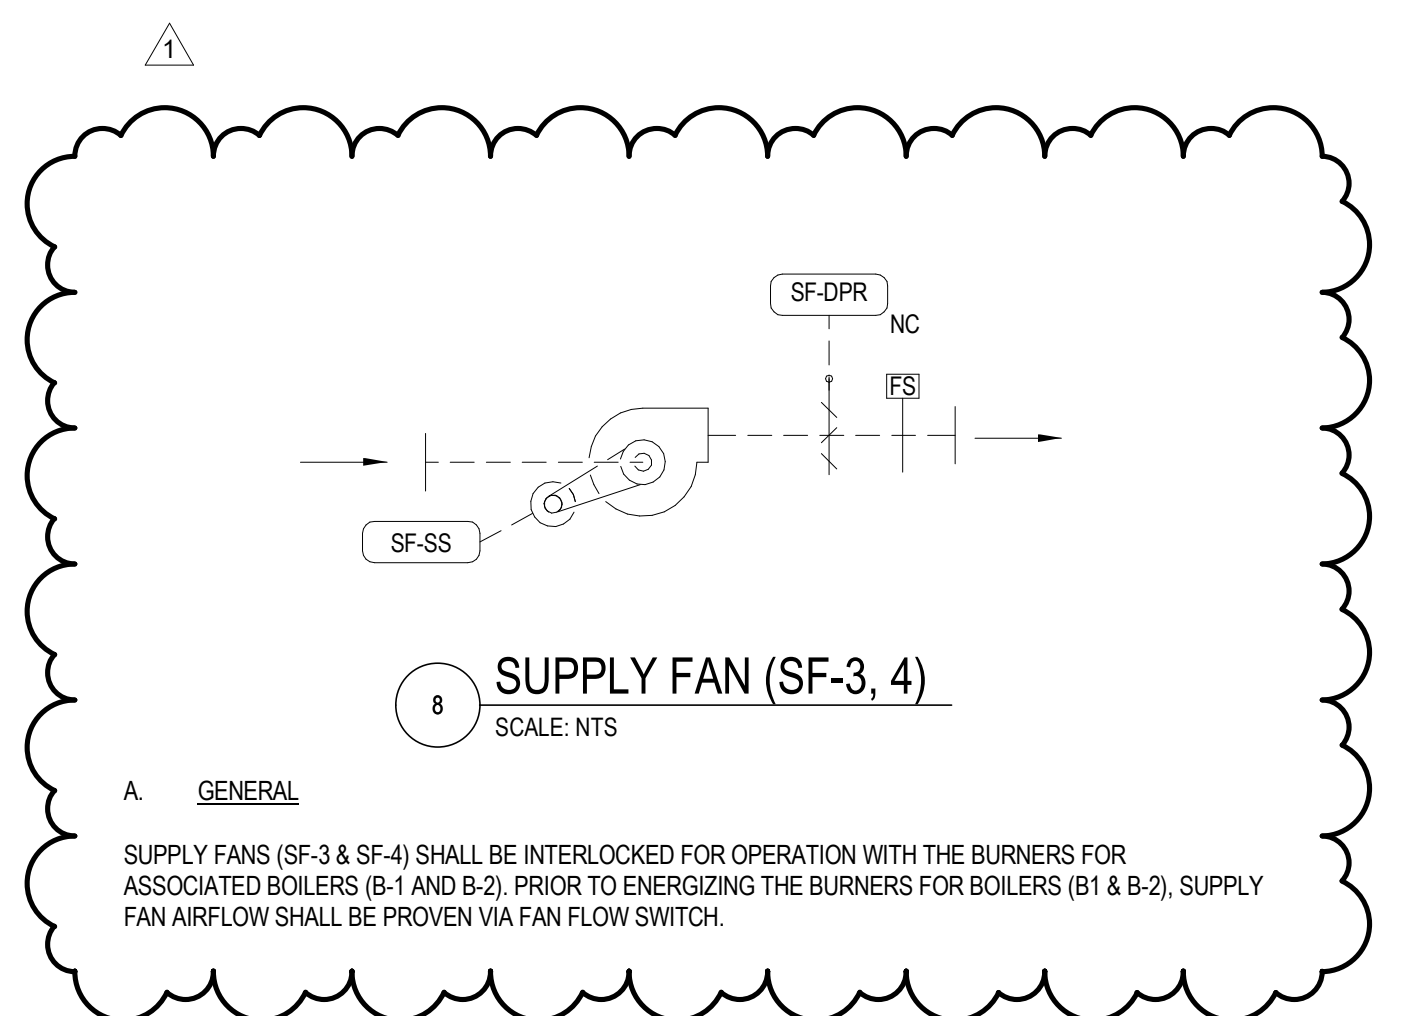

**8 SUPPLY FAN (SF-3, 4)**  
SCALE: NTS

**A. GENERAL:**  
SUPPLY FANS (SF-3 & SF-4) SHALL BE INTERLOCKED FOR OPERATION WITH THE BURNERS FOR ASSOCIATED BOILERS (B-1 AND B-2). PRIOR TO ENERGIZING THE BURNERS FOR BOILERS (B1 & B-2), SUPPLY FAN AIRFLOW SHALL BE PROVEN VIA FAN FLOW SWITCH.

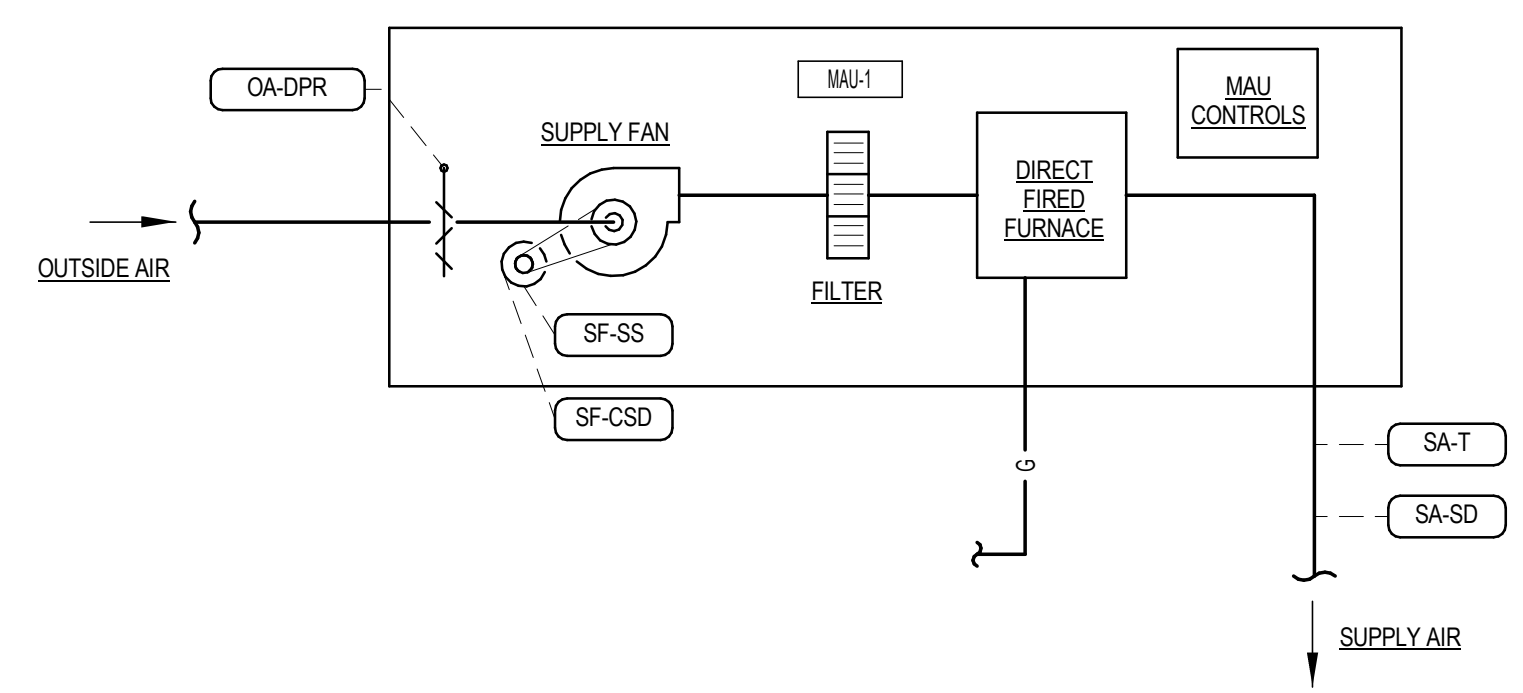


**7 MAKE-UP AIR UNIT**  
SCALE: NTS

**A. GENERAL:**  
THE MAKE-UP AIR UNIT (MAU-1) SERVES THE PUMP ROOM WITH TEMPERED AIR. THE MAU IS A GAS-FIRED SELF CONTAINED UNIT WITH MODULATING GAS FIRED DIRECT FURNACE. SAFETIES FOR THE GAS FIRED OPERATIONS ARE INCLUDED WITH THE MAU.


**B. SAFETIES:**  
UPON SENSING SMOKE AT THE SMOKE DETECTOR ON THE DISCHARGE AIR SIDE OF THE MAU, THE SUPPLY FAN SHALL STOP, THE GAS FIRED BURNER SHALL BE DEENERGIZED AND THE OA DAMPER SHALL CLOSE. AND AN ALARM SHALL BE TRIGGERED AT THE FIRE ALARM CONTROL PANEL.

REFER TO SAMPLE GRAPHIC HVAC UNIT REQUIREMENTS ON DRAWING H02-701

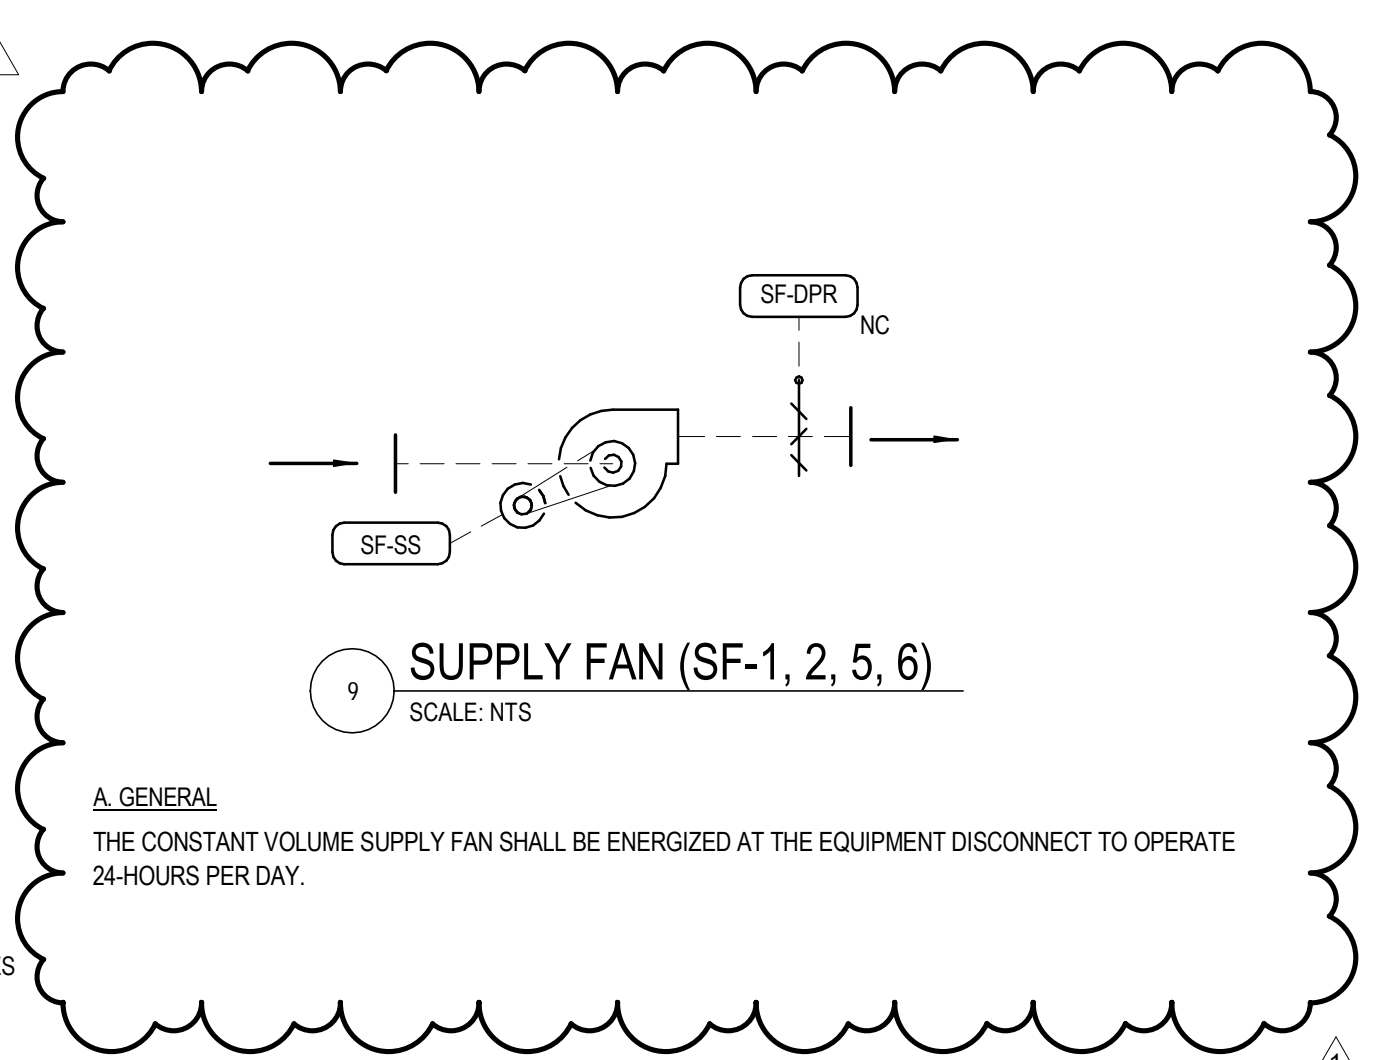

**9 SUPPLY FAN (SF-1, 2, 5, 6)**  
SCALE: NTS


**A. GENERAL:**  
THE CONSTANT VOLUME SUPPLY FAN SHALL BE ENERGIZED AT THE EQUIPMENT DISCONNECT TO OPERATE 24-HOURS PER DAY.

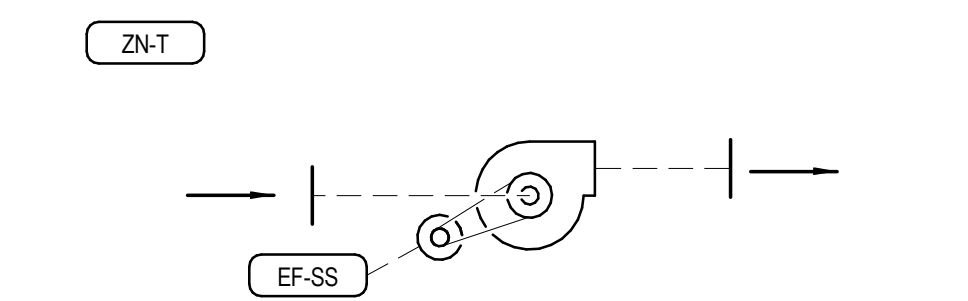


**6 HIGH TEMP EXHAUST FAN (EF-7 & 8)**  
SCALE: NTS

**A. GENERAL:**  
1. WHEN THE SPACE TEMPERATURE EXCEEDS SETPOINT (80°F ADJ.) THE EXHAUST FAN SHALL ENERGIZE.  
2. WHEN SPACE TEMPERATURE DROPS 5°F (ADJ.) BELOW SETPOINT, EXHAUST FAN SHALL DE-ENERGIZE.

PROFESSIONAL CERTIFICATION. I CERTIFY THAT THESE DOCUMENTS WERE PREPARED OR APPROVED BY ME, AND THAT I AM A DULY LICENSED ENGINEER UNDER THE LAWS OF THE STATE OF MARYLAND. LICENSE NO. 35170, EXPIRATION DATE 6/6/2026

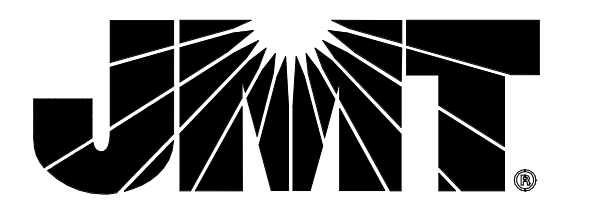

40 WIGHT AVENUE | HUNT VALLEY, MD 21030  
P: (410) 329-3100 | F: (410) 472-2200 | www.jmt.com



CITY OF BALTIMORE  
DEPARTMENT OF PUBLIC WORKS  
OFFICE OF ENGINEERING & CONSTRUCTION

SANITARY CONTRACT NO. 982R  
EASTERN AVENUE PUMP STATION REHABILITATION

**HVAC CONTROLS I**

SCALE: AS NOTED

DATE: JUNE 2024

DRAWING NO.: H02-701

SHEET 86 OF 148

PROFESSIONAL CERTIFICATION. I CERTIFY THAT THESE DOCUMENTS WERE PREPARED OR APPROVED BY ME, AND THAT I AM A DULY LICENSED ENGINEER UNDER THE LAWS OF THE STATE OF MARYLAND. LICENSE NO. 35170, EXPIRATION DATE 6/6/2026